


Mr. SAM SMALL
 TMK: (2) 2-4-19:8
 March 18, 2000

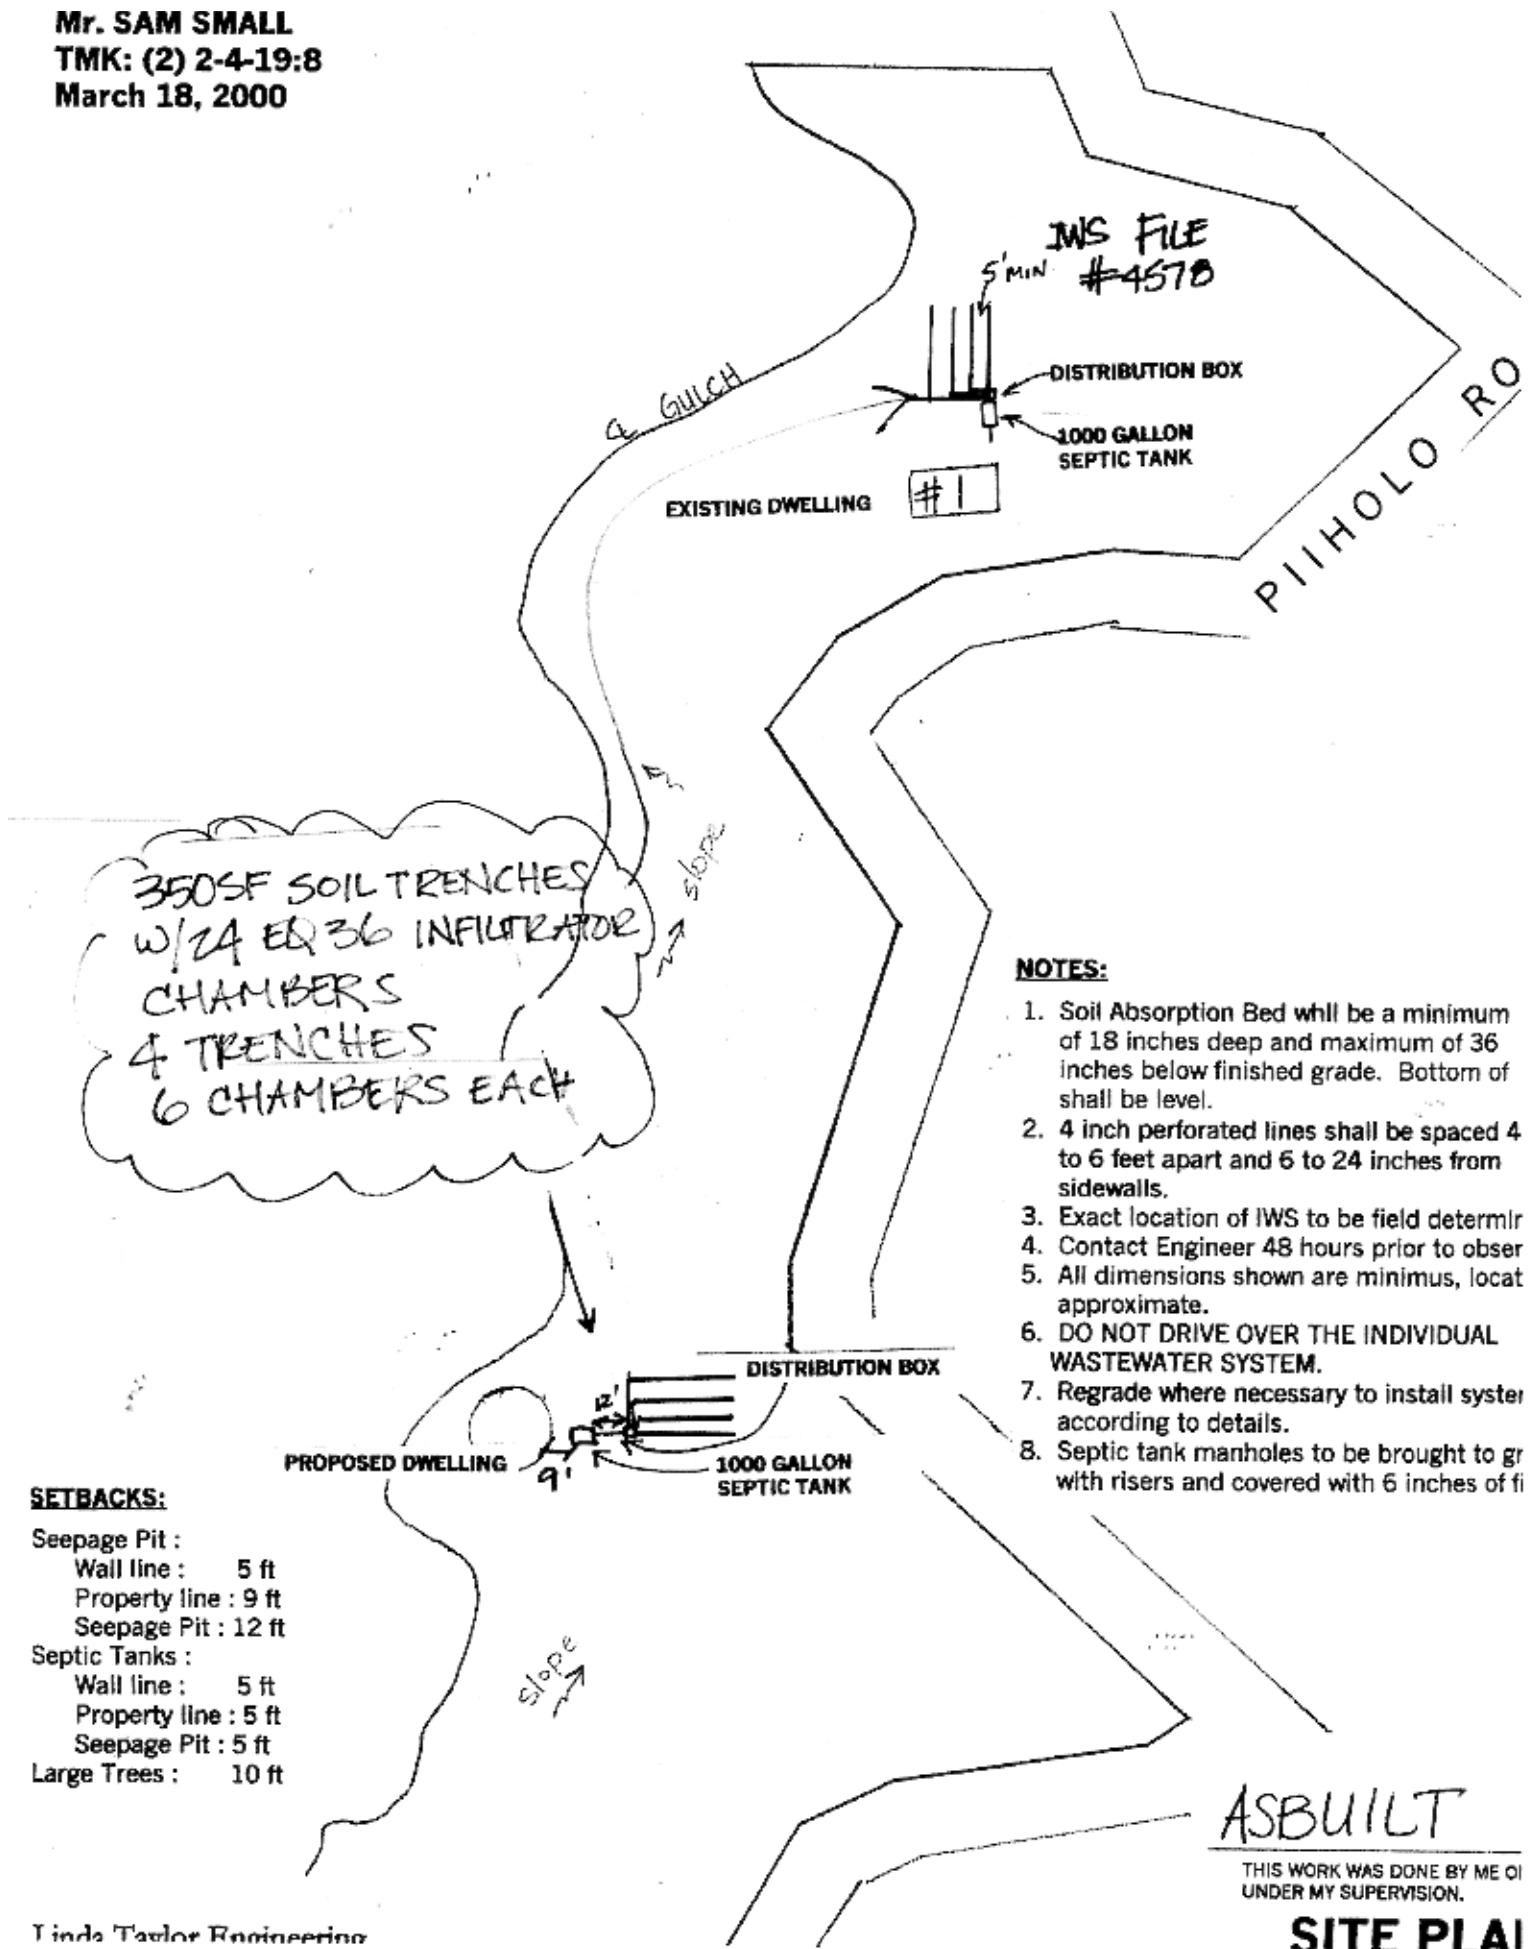

350SF SOIL TRENCHES
 W/ 24 EQ 36 INFILTRATOR
 CHAMBERS
 4 TRENCHES
 6 CHAMBERS EACH

NOTES:

1. Soil Absorption Bed shall be a minimum of 18 inches deep and maximum of 36 inches below finished grade. Bottom of shall be level.
2. 4 inch perforated lines shall be spaced 4 to 6 feet apart and 6 to 24 inches from sidewalls.
3. Exact location of IWS to be field determined.
4. Contact Engineer 48 hours prior to observe.
5. All dimensions shown are minimum, locate approximate.
6. DO NOT DRIVE OVER THE INDIVIDUAL WASTEWATER SYSTEM.
7. Regrade where necessary to install system according to details.
8. Septic tank manholes to be brought to grade with risers and covered with 6 inches of finish.

SETBACKS:

- Seepage Pit :
 Wall line : 5 ft
 Property line : 9 ft
 Seepage Pit : 12 ft
- Septic Tanks :
 Wall line : 5 ft
 Property line : 5 ft
 Seepage Pit : 5 ft
- Large Trees : 10 ft

ASBUILT
 THIS WORK WAS DONE BY ME OR
 UNDER MY SUPERVISION.
SITE PLAN